
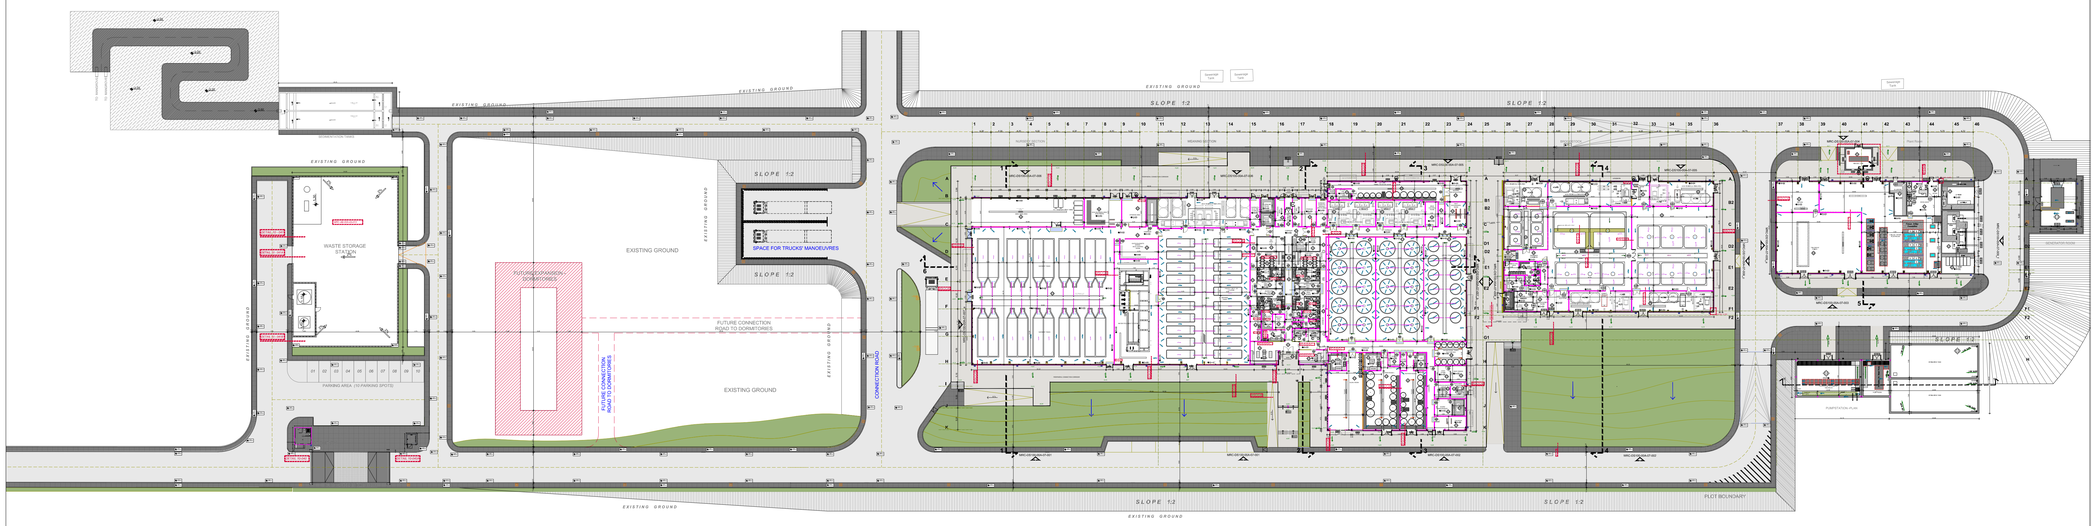


AS BUILT DRAWING

Key Plan

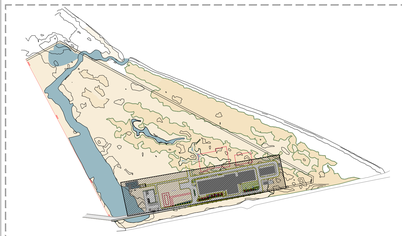

REV	DATE	DESCRIPTION	BY
00	15-03-2015	ISSUED FOR APPROVAL	K.K.R

PROJECT:

مركز الشيخ خليفة للابحاث البحرية في امارة أم القيوين

Sheikh Khalifa Bin Zayed Centre For Marine Research
Umm Al Quwain

CLIENT:

وزارة شؤون الرئاسة
مبادرات صاحب السمو رئيس الدولة
(حفظه الله ورعاه)

MINISTRY OF PRESIDENTIAL AFFAIRS
INITIATIVES OF H.H. THE PRESIDENT OF UAE

UNITED ARAB EMIRATES
MINISTRY OF PUBLIC WORKS

MAIN CONSULTANT:

the CORE ALLIANCE
Engineering Consultancy

DESIGN CONSULTANT:

JUMAIRA INTERNATIONAL CONSULTANTS

JUMAIRA INTERNATIONAL CONSULTANT

MAIN CONTRACTOR:

GHANTOOT TRANSPORT & Gen.Cont.Est. (Building Division)

NEAR MAIN BUS TERMINAL
MUROOR ROAD-ABU DHABI
UNITED ARAB EMIRATES

E-mail:gbt@ghantootgroup.ae
Web site:www.ghantootgroup.com
TELEPHONE 02-4414151
FAX. 02-6412010

DRAWING TITLE:

GROUND FLOOR PLAN

SCALE	DRAWN	CHECKED	APPROVED	SHEET	REVISION
1:500	K.K.R	Eng.Zuber	Eng.Jalal	A0	00

PROJECT No.	DATE	DRAWING NO.
J-064	15-03-2015	MRC-AB-00A-02-003

LAST SAVE:- 2015/09/03 – 10:18am
PATH:- C:\Users\User\Desktop\ARCHITECTURAL\AUTOCAD FILE\02_PLANS\1\MRC-AB-00A-02-003-007.dwg